


**CASE STUDY #1**  
**OFFICE TENANT**  
**MULTI-STORY BUILDING - 10,000 SF**  
**REMODEL**

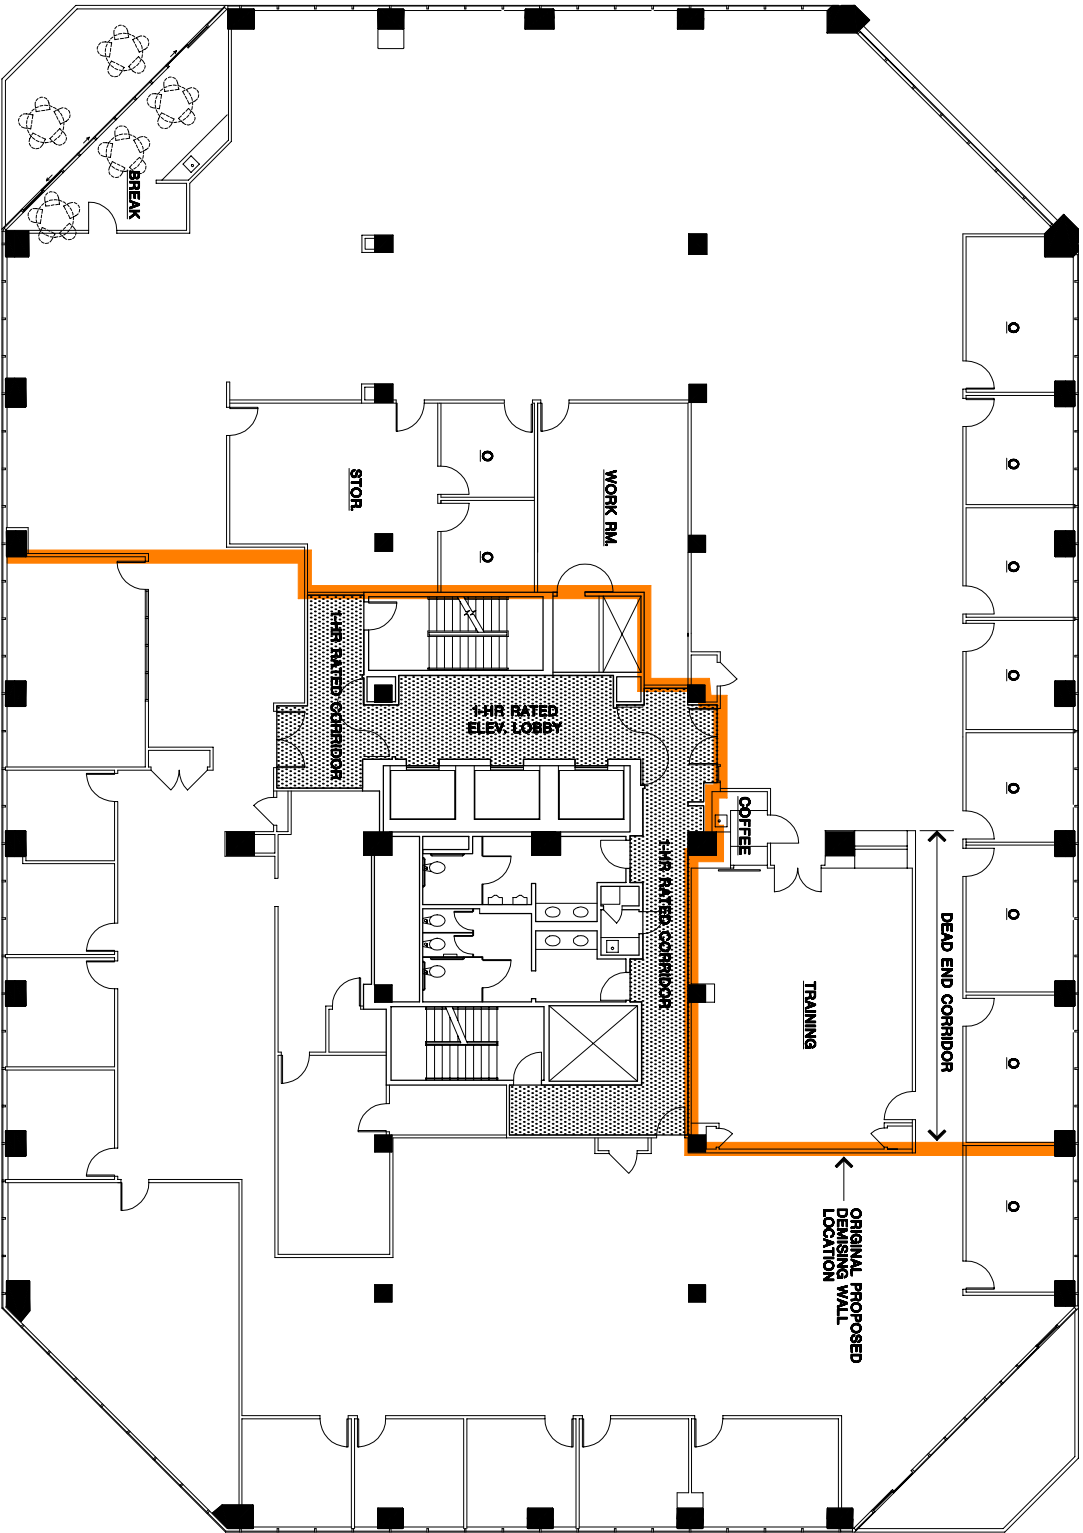

**BEFORE**